

REVISIONS		
NO.	BY	DATE
ORIG: 13587	RHD	01-21-25
REDRAW: N/A	N/A	N/A


**SARATOGA SPRINGS WTP
POTABLE WATER**

Engineer:
unavailable

CCUA
3176 Old Jennings Road
Middleburg, FL 32068
904-272-5999

Contractor:
Petticoat-Schmitt Civil
Contractors, Inc.



**WTP
SSWTP-01
W-01**

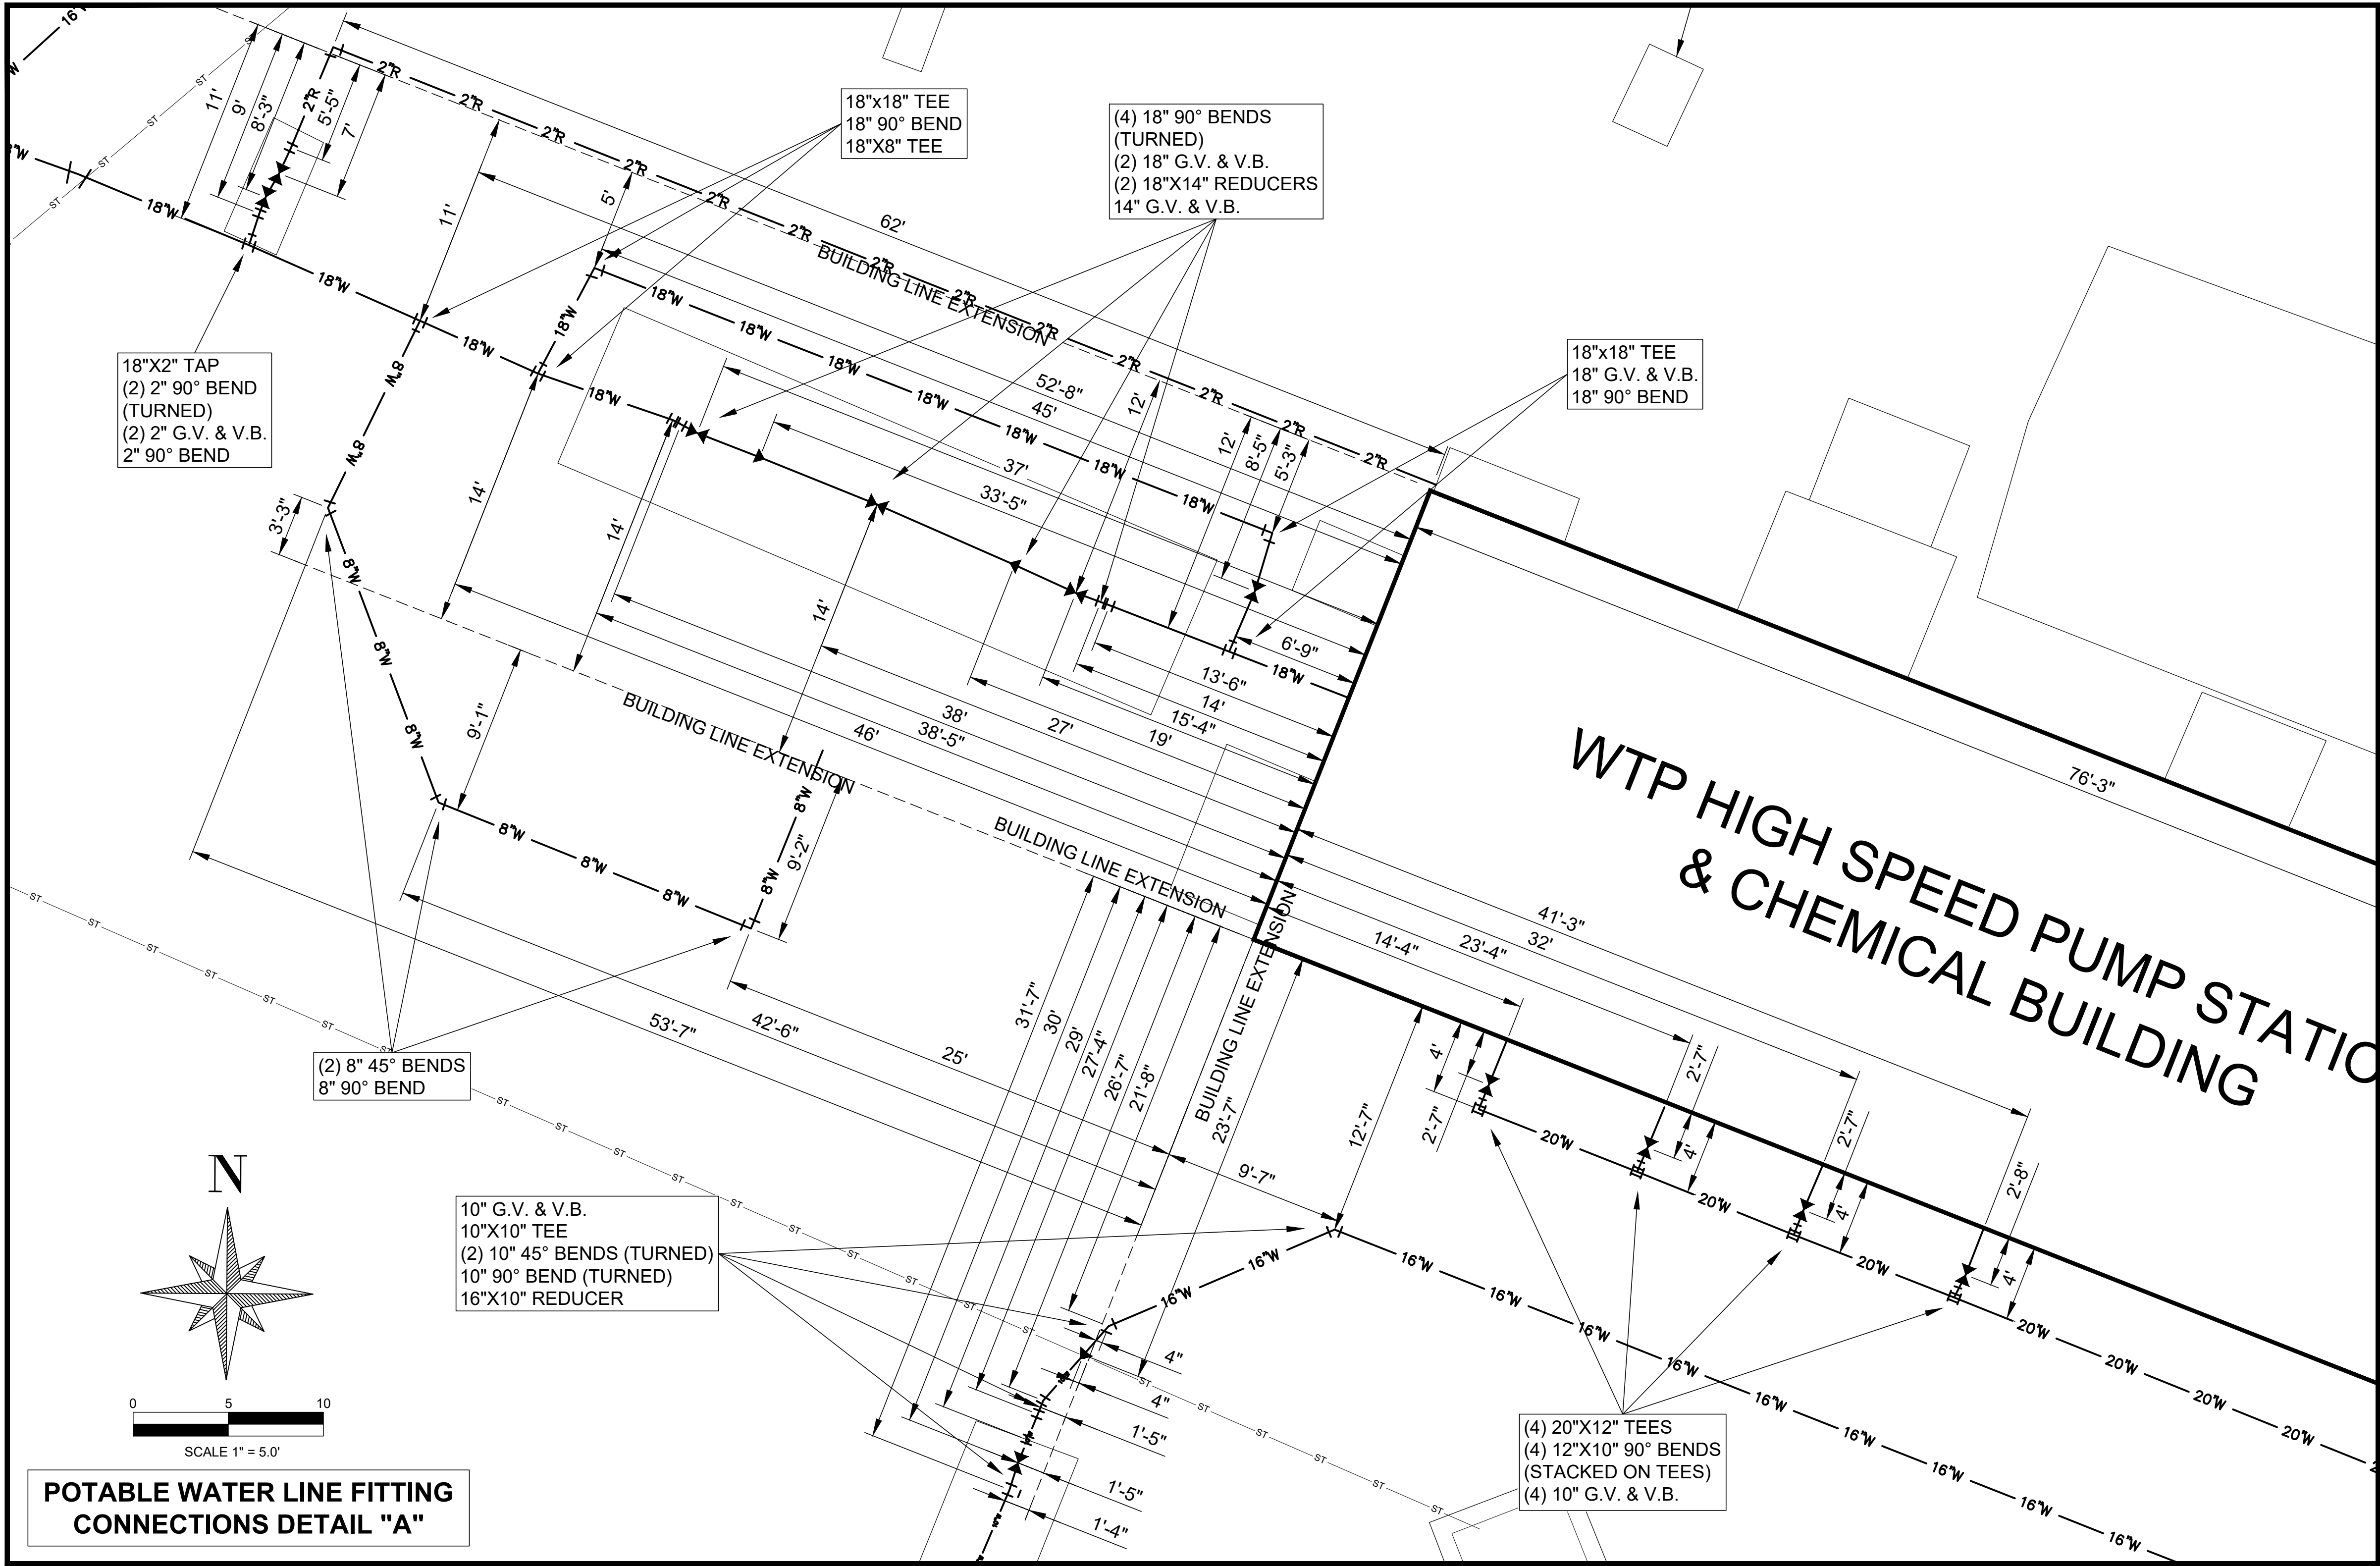

POTABLE WATER LINE FITTING
CONNECTIONS DETAIL "A"

REVISIONS		
NO.	BY	DATE
ORIG: 13587	RHD	01-21-25
REDRAW: N/A	N/A	N/A

SARATOGA SPRINGS WTP POTABLE WATER DETAIL	
Engineer: unavailable	Contractor: Petticoat-Schmitt Civil Contractors, Inc.
CCUA 3176 Old Jennings Road Middleburg, FL 32068 904-272-5999	WTP SSWTP-01 W-02

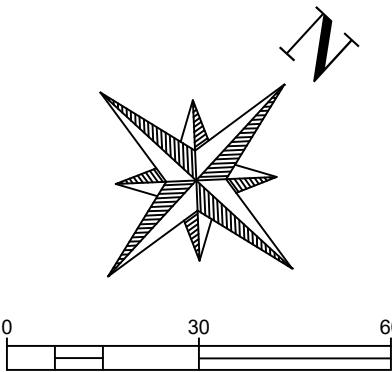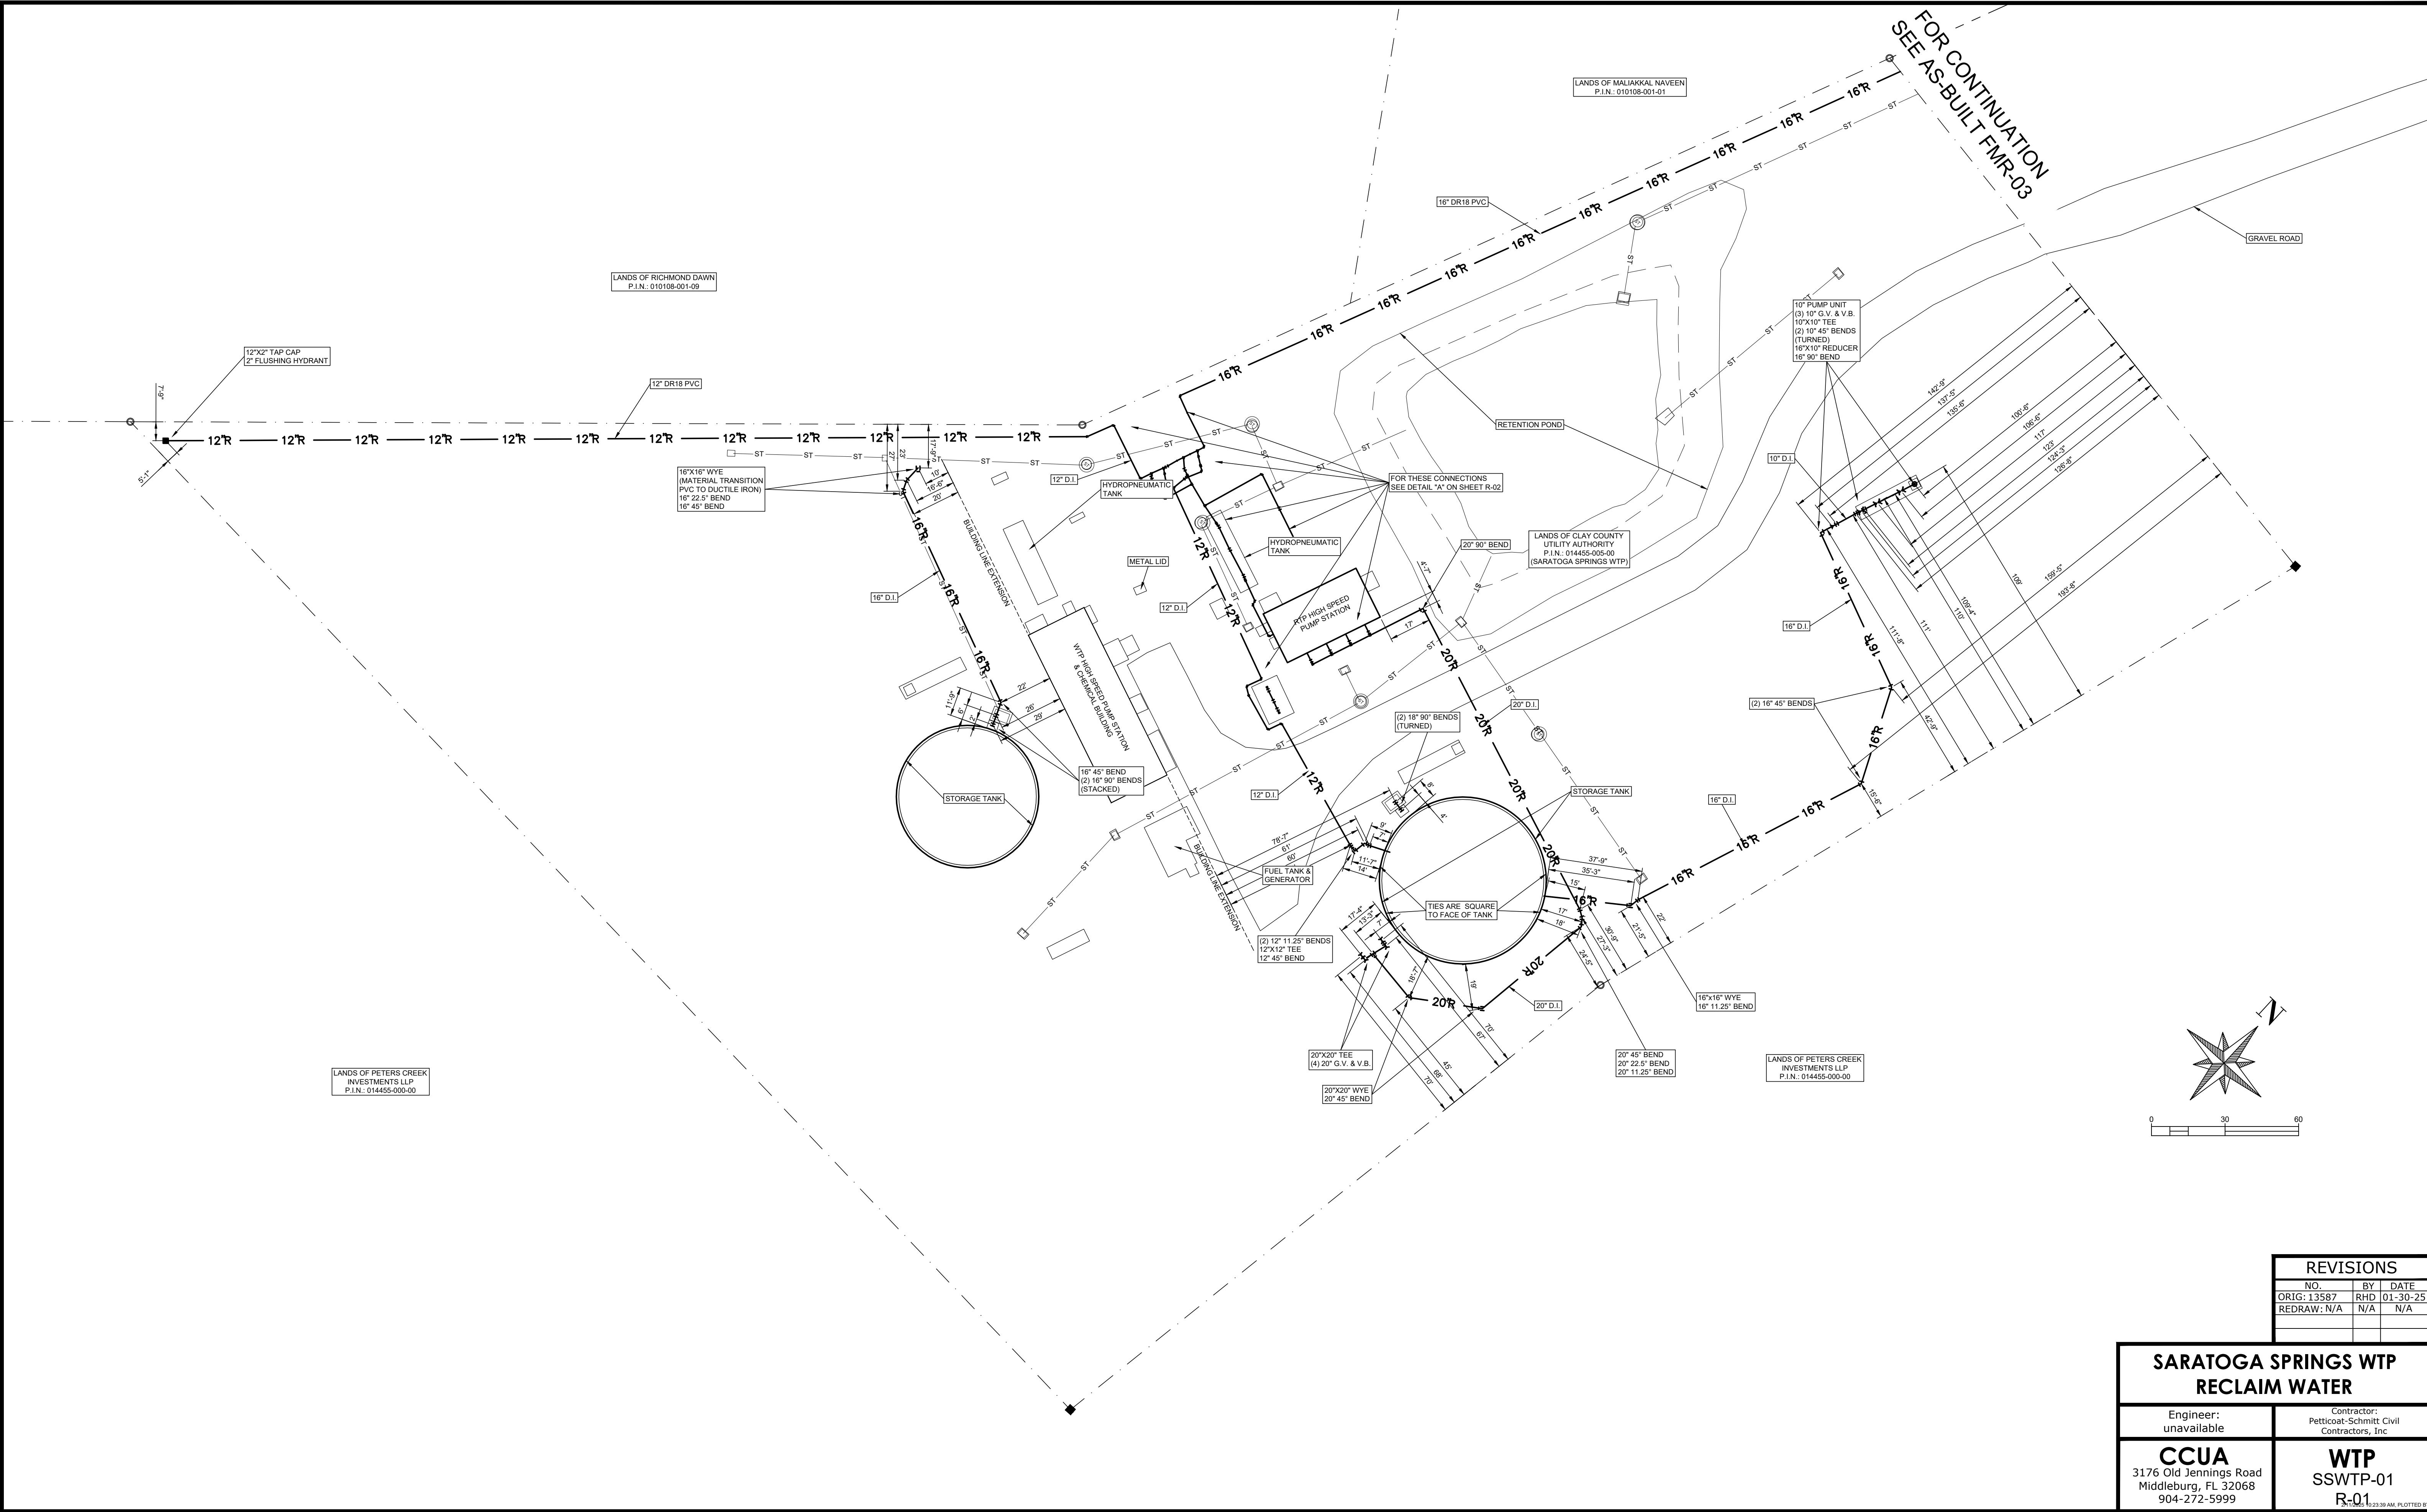

REVISIONS		
NO.	BY	DATE
ORIG: 13587	RHD	01-30-25
REDRAW: N/A	N/A	N/A


**SARATOGA SPRINGS WTP
RECLAIM WATER**

Engineer:
unavailable

CCUA
3176 Old Jennings Road
Middleburg, FL 32068
904-272-5999

Contractor:
Petticoat-Schmitt Civil
Contractors, Inc

**WTP
SSWTP-01
R-01**

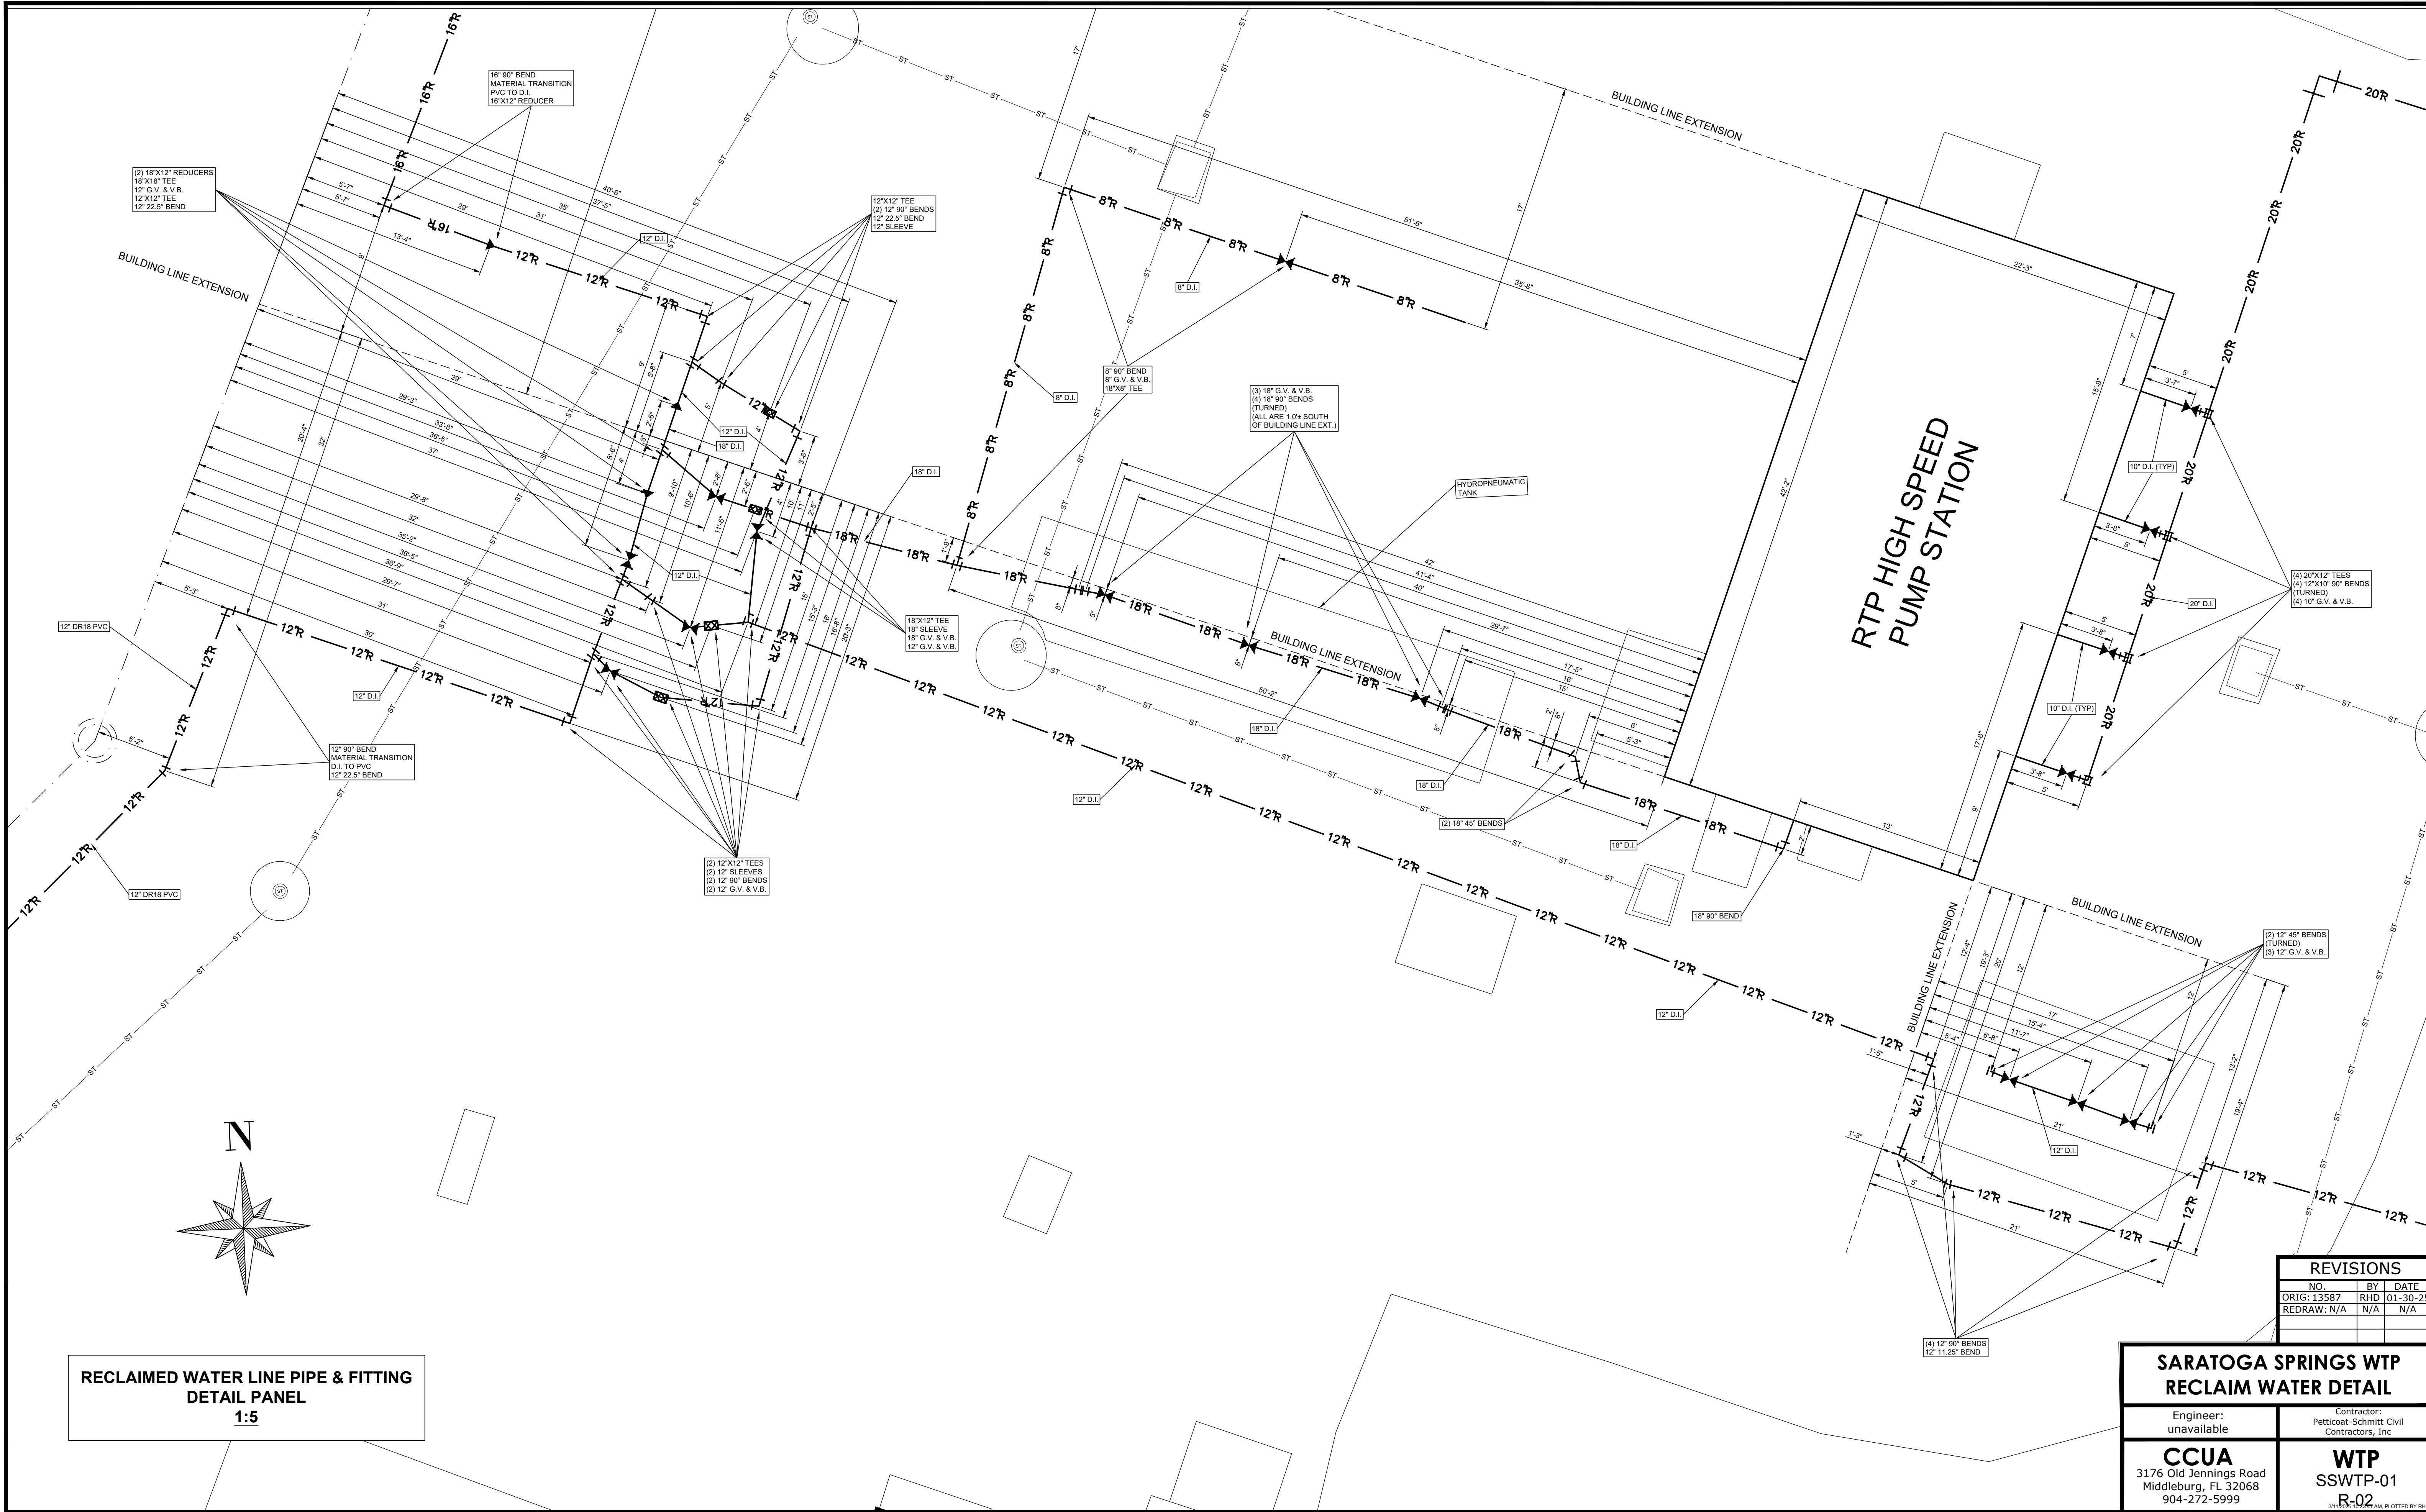

RECLAIMED WATER LINE PIPE & FITTING
DETAIL PANEL
1:5

REVISIONS		
NO.	BY	DATE
ORIG: 13587	RHD	01-30-25
REDRAW: N/A	N/A	N/A


**SARATOGA SPRINGS WTP
RECLAIM WATER DETAIL**

Engineer:
unavailable

CCUA
3176 Old Jennings Road
Middleburg, FL 32068
904-272-5999

Contractor:
Petticoat-Schmitt Civil
Contractors, Inc

**WTP
SSWTP-01
R-02**

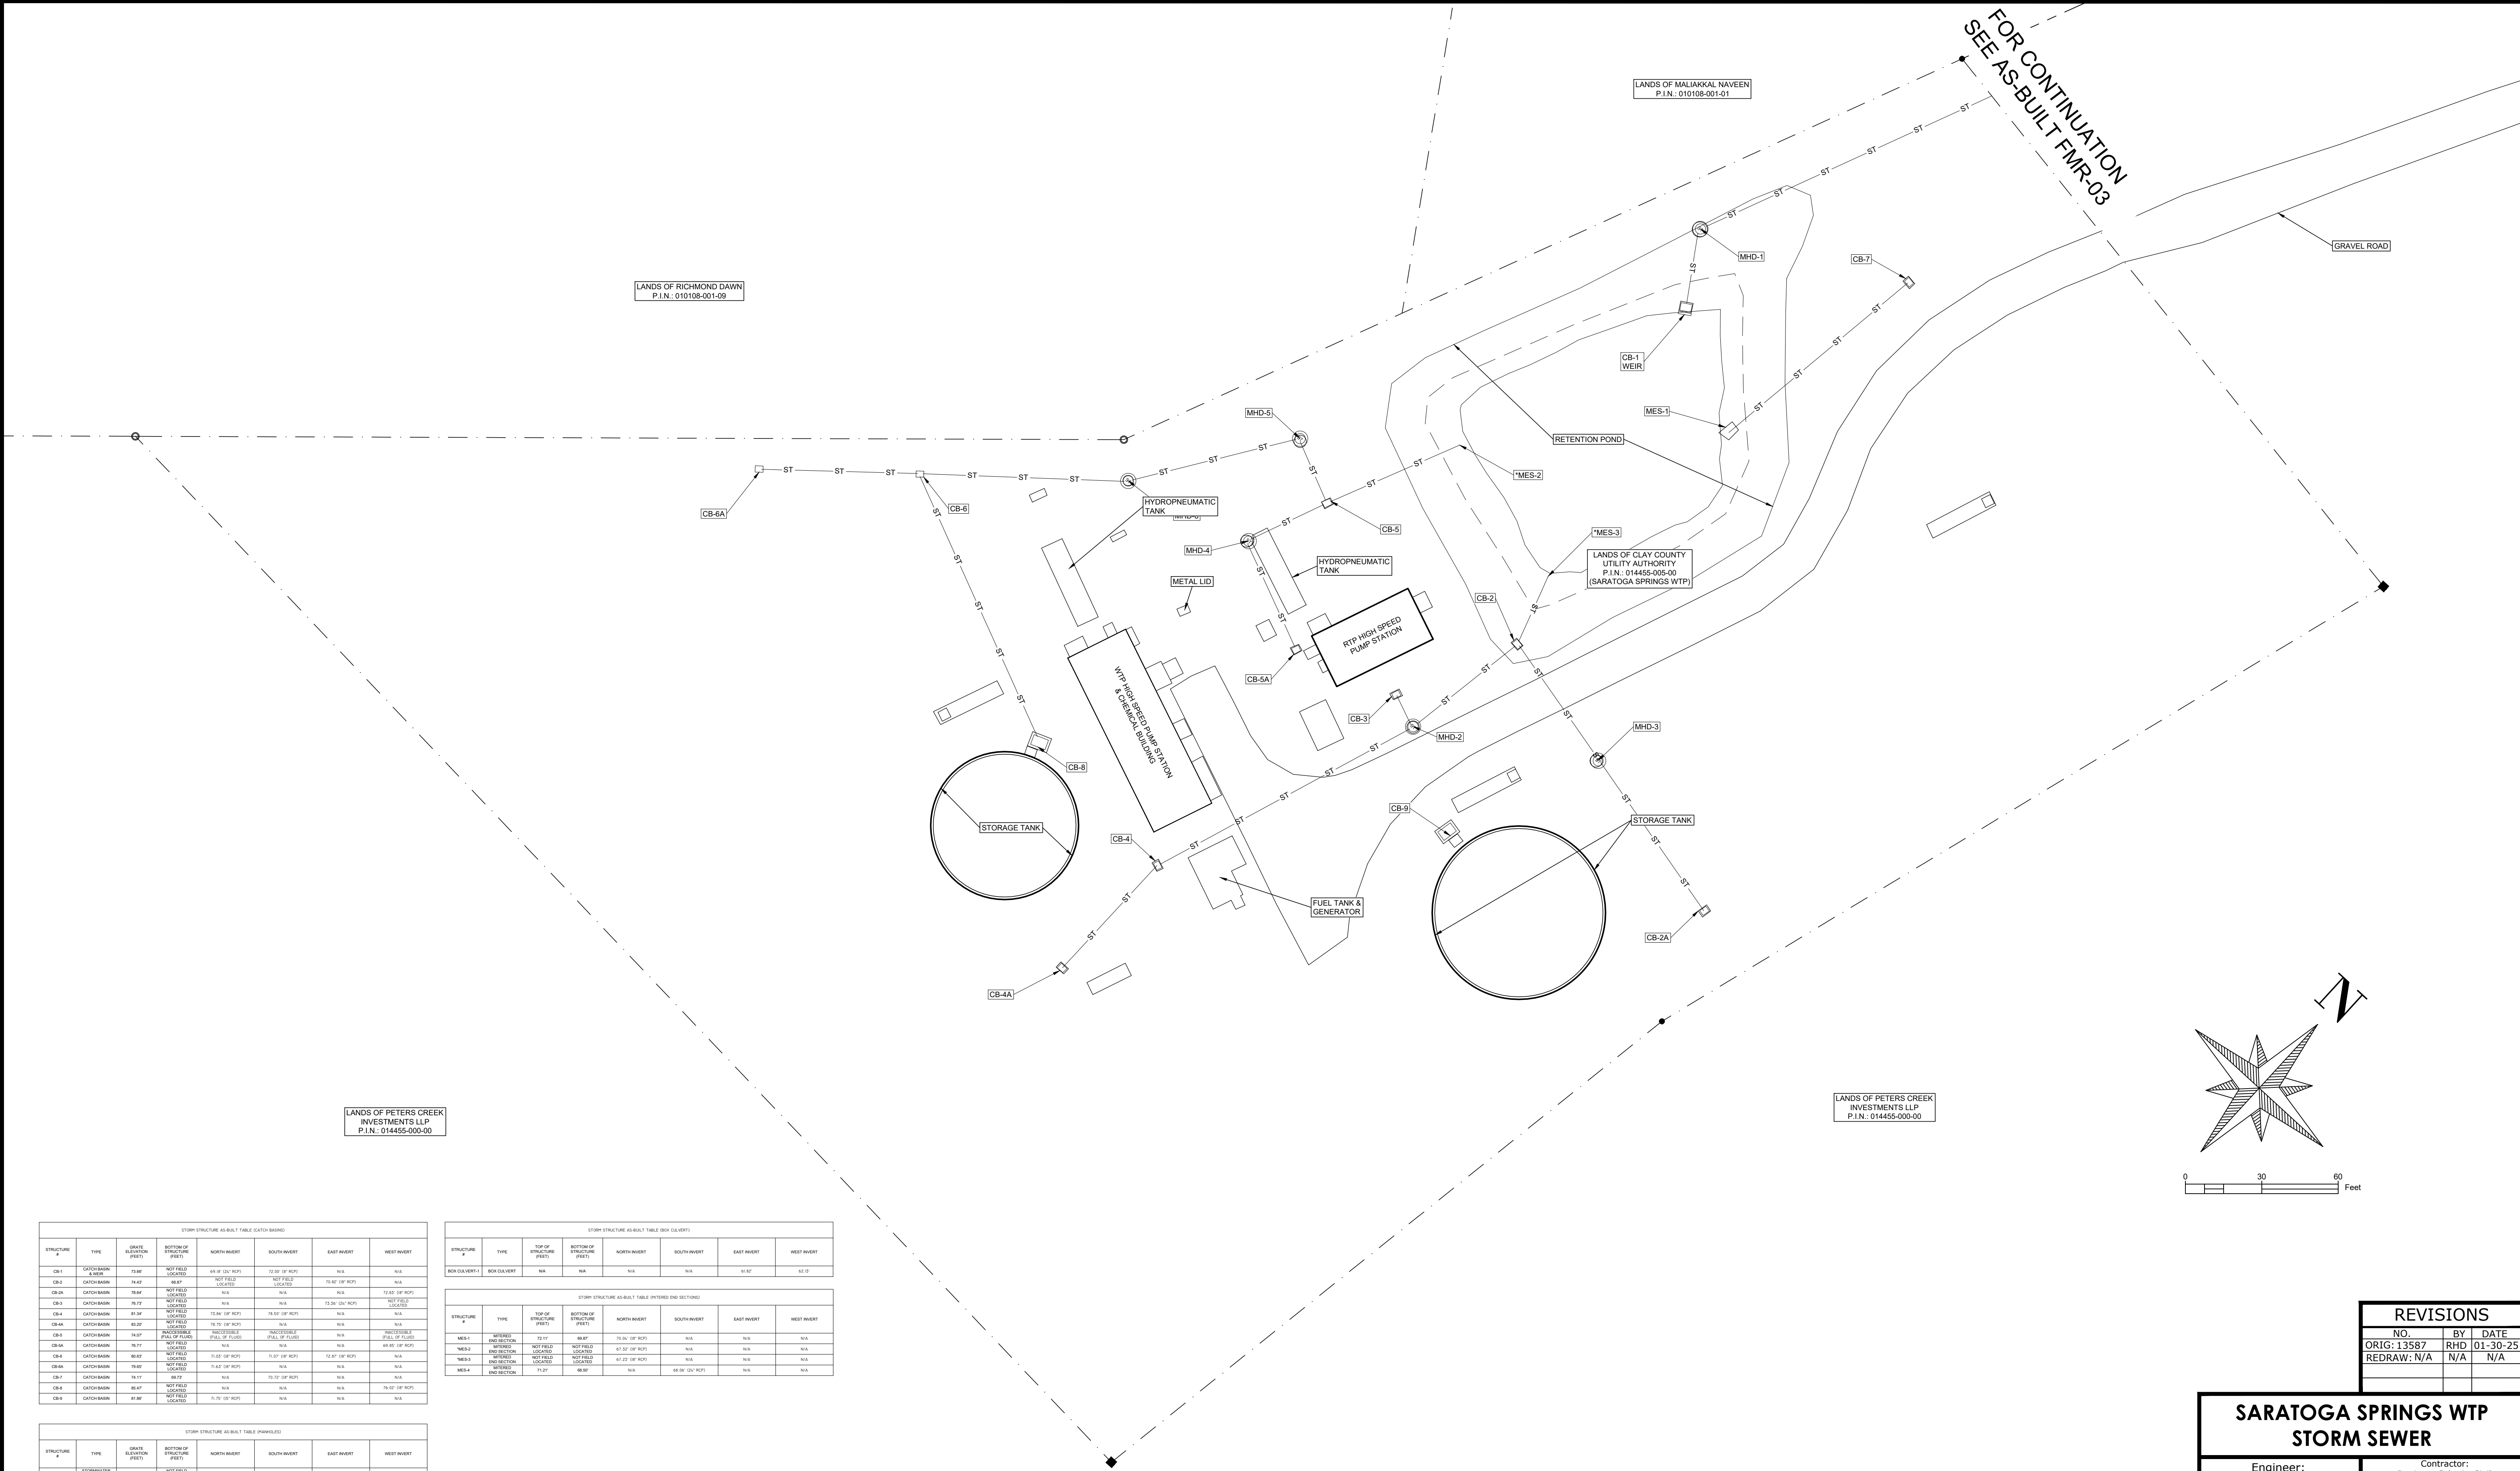


FOR CONTINUATION
SEE AS-BUILT FMR-03

STORM STRUCTURE AS-BUILT TABLE (CATCH BASINS)						
STRUCTURE #	TYPE	GRATE ELEVATION (FEET)	BOTTOM OF STRUCTURE (FEET)	NORTH INVERT	SOUTH INVERT	EAST INVERT
CB-1	CATCH BASIN & MANHOLE	73.967	NOT FIELD LOCATED	69.87 (24" RCP)	72.007 (8" RCP)	N/A
CB-2	CATCH BASIN	74.42	NOT FIELD LOCATED	70.62 (8" RCP)	72.87 (8" RCP)	N/A
CB-3A	CATCH BASIN	73.94	NOT FIELD LOCATED	N/A	72.39 (24" RCP)	N/A
CB-3	CATCH BASIN	76.72	NOT FIELD LOCATED	N/A	72.39 (24" RCP)	N/A
CB-4	CATCH BASIN	81.34	NOT FIELD LOCATED	73.84 (8" RCP)	74.34 (8" RCP)	N/A
CB-4A	CATCH BASIN	82.307	NOT FIELD LOCATED	74.75 (8" RCP)	N/A	N/A
CB-5	CATCH BASIN	74.07	NOT FIELD LOCATED	70.62 (8" RCP)	72.87 (8" RCP)	N/A
CB-5A	CATCH BASIN	76.77	NOT FIELD LOCATED	N/A	72.87 (8" RCP)	N/A
CB-6	CATCH BASIN	86.88	NOT FIELD LOCATED	71.82 (8" RCP)	72.87 (8" RCP)	N/A
CB-6A	CATCH BASIN	79.65	NOT FIELD LOCATED	71.82 (8" RCP)	N/A	N/A
CB-7	CATCH BASIN	74.11	NOT FIELD LOCATED	70.12 (8" RCP)	N/A	N/A
CB-8	CATCH BASIN	88.47	NOT FIELD LOCATED	N/A	N/A	75.02 (8" RCP)
CB-9	CATCH BASIN	81.867	NOT FIELD LOCATED	71.75 (8" RCP)	N/A	N/A

STORM STRUCTURE AS-BUILT TABLE (MANHOLES)						
STRUCTURE #	TYPE	GRATE ELEVATION (FEET)	BOTTOM OF STRUCTURE (FEET)	NORTH INVERT	SOUTH INVERT	EAST INVERT
MHD-1	STORMWATER MANHOLE	74.82	NOT FIELD LOCATED	69.87 (24" RCP)	68.74 (24" RCP)	N/A
MHD-2	STORMWATER MANHOLE	76.19	NOT FIELD LOCATED	67.44 (8" RCP)	72.007 (8" RCP)	N/A
MHD-3	STORMWATER MANHOLE	79.58	NOT FIELD LOCATED	N/A	71.84 (8" RCP)	72.51 (8" RCP)
MHD-4	STORMWATER MANHOLE	76.88	NOT FIELD LOCATED	69.55 (8" RCP)	N/A	69.57 (8" RCP)
MHD-5	STORMWATER MANHOLE	77.18	NOT FIELD LOCATED	N/A	68.16 (8" RCP)	68.30 (8" RCP)
MHD-6	STORMWATER MANHOLE	79.06	NOT FIELD LOCATED	68.84 (8" RCP)	70.12 (8" RCP)	N/A

STORM STRUCTURE AS-BUILT TABLE (BOX CULVERT)						
STRUCTURE #	TYPE	TOP OF STRUCTURE (FEET)	BOTTOM OF STRUCTURE (FEET)	NORTH INVERT	SOUTH INVERT	EAST INVERT
BOX CULVERT-1	BOX CULVERT	N/A	N/A	N/A	N/A	62.02

STORM STRUCTURE AS-BUILT TABLE (OTHER END SECTIONS)						
STRUCTURE #	TYPE	TOP OF STRUCTURE (FEET)	BOTTOM OF STRUCTURE (FEET)	NORTH INVERT	SOUTH INVERT	EAST INVERT
MES-1	METERED END SECTION	72.17	68.87	73.04 (8" RCP)	N/A	N/A
MES-2	METERED END SECTION	NOT FIELD LOCATED	NOT FIELD LOCATED	67.32 (8" RCP)	N/A	N/A
MES-3	METERED END SECTION	NOT FIELD LOCATED	NOT FIELD LOCATED	67.22 (8" RCP)	N/A	N/A
MES-4	METERED END SECTION	71.27	68.87	N/A	68.00 (24" RCP)	N/A

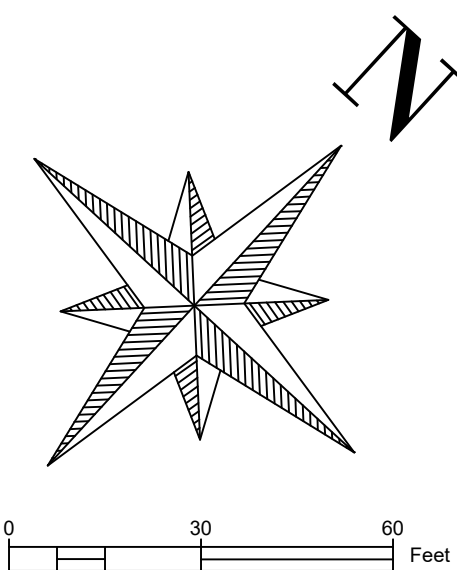

REVISIONS

NO.	BY	DATE
ORIG: 13587	RHD	01-30-25
REDRAW: N/A	N/A	N/A

**SARATOGA SPRINGS WTP
STORM SEWER**

Engineer: unavailable	Contractor: Petticoat-Schmitt Civil Contractors, Inc
CCUA 3176 Old Jennings Road Middleburg, FL 32068 904-272-5999	WTP SSWTP-01 SS-01

3/25/2025 10:22:24 AM PLOTTED BY: RHD